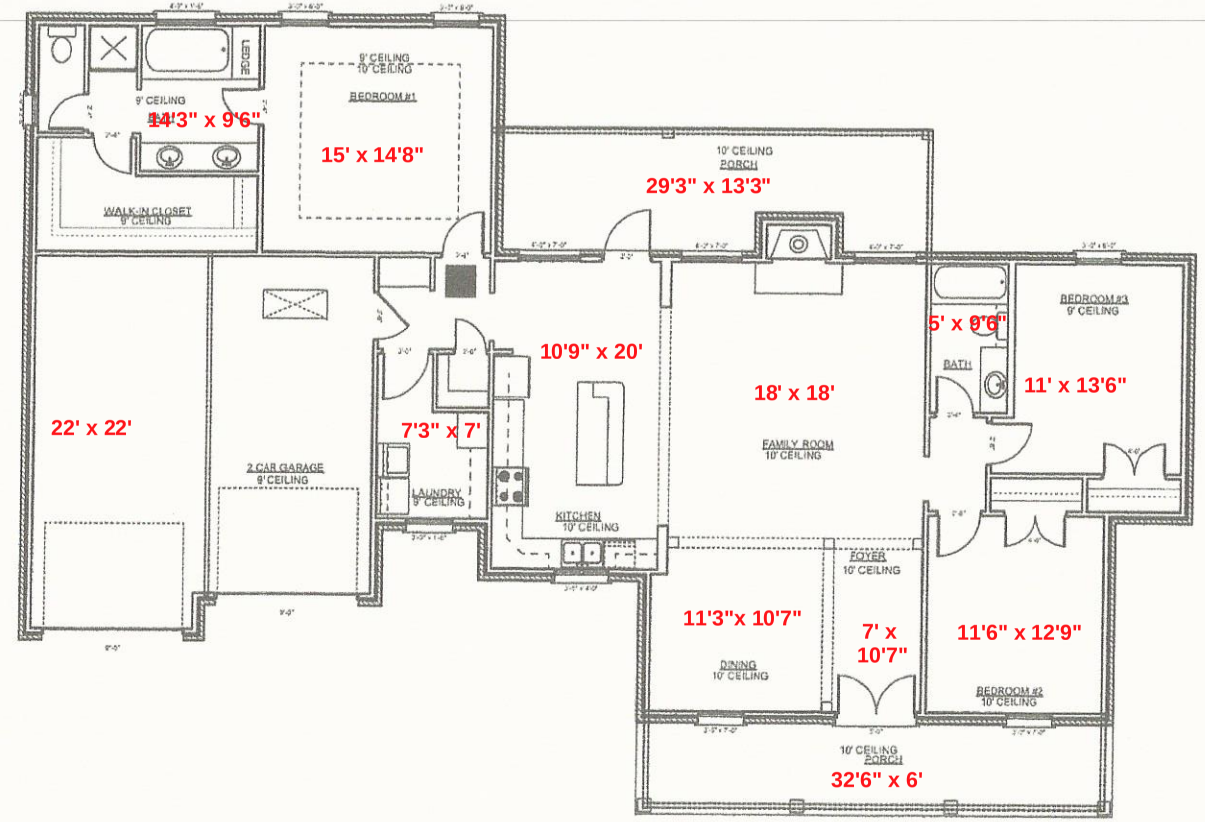

1923 ~~1864~~ S/F LIVING AREA
3052 ~~2841~~ S/F TOTAL AREA

ALL PLANS ARE DRAWN TO OWNERS SPECIFICATIONS
CODE COMPLIANCE IS THE RESPONSIBILITY OF THE OWNER/ CONTRACTOR
VERIFY ALL DIMENSIONS AND CLEARANCES
PLANS APPROVED BY _____

DRAWING#
REVISED
APPROVED
DRAWN BY

LOT 96 J. NATALI